

## ADDENDUM NO. 2

---

To: Construction Documents dated March 27, 2026

Project: BL000A Site - Woodlawn Stormwater Collection System (Railroad)  
IU 20192159

BRCJ Project No.: 10570

Date: April 15, 2026

---

This Addendum, issued prior to bidding alters, amends, corrects, or clarifies the Proposal Documents to the extent stated herein and does thereby become a part of the Proposal Documents and will become part of the Contract Documents is the successful bidder.

---

### ITEMS INCLUDED IN THIS ADDENDUM

- A. Answers to questions as noted below.
- B. Exhibits indicating contractor staging area and depth of Chilled water infrastructure.

### ANSWERS TO QUESTIONS

- Q1: How deep are the chilled water lines under the east curb line?  
A1: The chilled water return line was potholed at one location on Friday April 10, 2026, and found to be 64" below asphalt near the proposed location of inlet STR-202. It is expected that the proposed storm inlets and piping will be installed above the chilled water lines without conflict. Refer to chilled water informational exhibits included in this Addendum, below.
- Q2: Where will contractor staging or parking be located?  
A2: Six parking spaces will be reserved for contractor use in the parking lot to the west. The area must be surrounded with temporary construction fencing having red screen fabric per standard IU protocol. The area may only be used to store materials or construction equipment; vehicles are not allowed to be parked within areas reserved for laydown. If additional parking is needed for Contractor personnel, they may park in the Green Lot near Assembly Hall and shuttle to the construction site. Refer to staging area exhibit, attached to this Addendum, below.
- Q3: How should we handle repairs to the irrigation system?  
A3: The existing irrigation system in the tree plot along Woodlawn avenue could be damaged in 3 or 4 locations during project excavation. Contractor is instructed to minimize damage to the extent practicable, and call Jim Hollars (812-320-7454) directly at Natures Way whenever the irrigation system is cut or damaged. IU will compensate NW for the irrigation repairs at no cost to the Contractor.

### CHANGES TO PROJECT MANUAL

None

### CHANGES TO PROJECT PLANS


**Plan Sheet C102 – Maintenance of Traffic Plan**  
**Add General Note E, as follows:**

E. Signage indicating “Sidewalk Closed Cross Here” shall be mounted on a Type III barricade positioned to block the sidewalk on the west side of Woodlawn Ave, and direct pedestrians to the east sidewalk, which shall remain open for the duration of the project.

**ATTACHMENTS**


**1. Contractor Staging Area Exhibit**

Contractor may use six parking spaces indicated in red for staging and storage. The area must be surrounded with temporary construction fencing having red screen fabric per standard IU protocol.

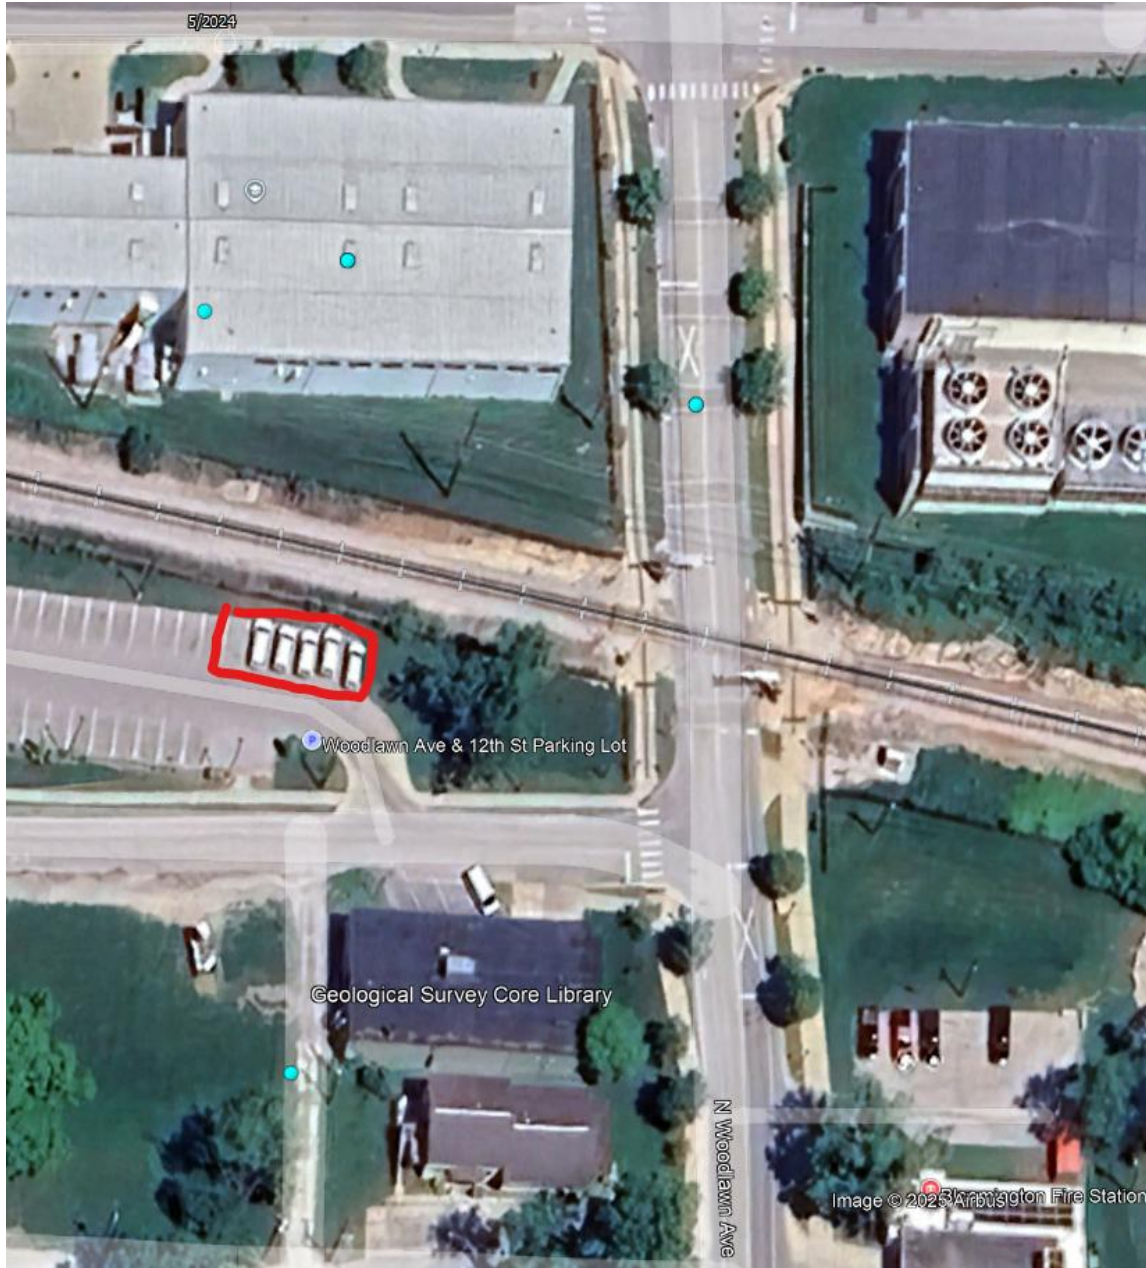



B. Excerpt from Plan Sheet C301 with utility exploration findings in red.

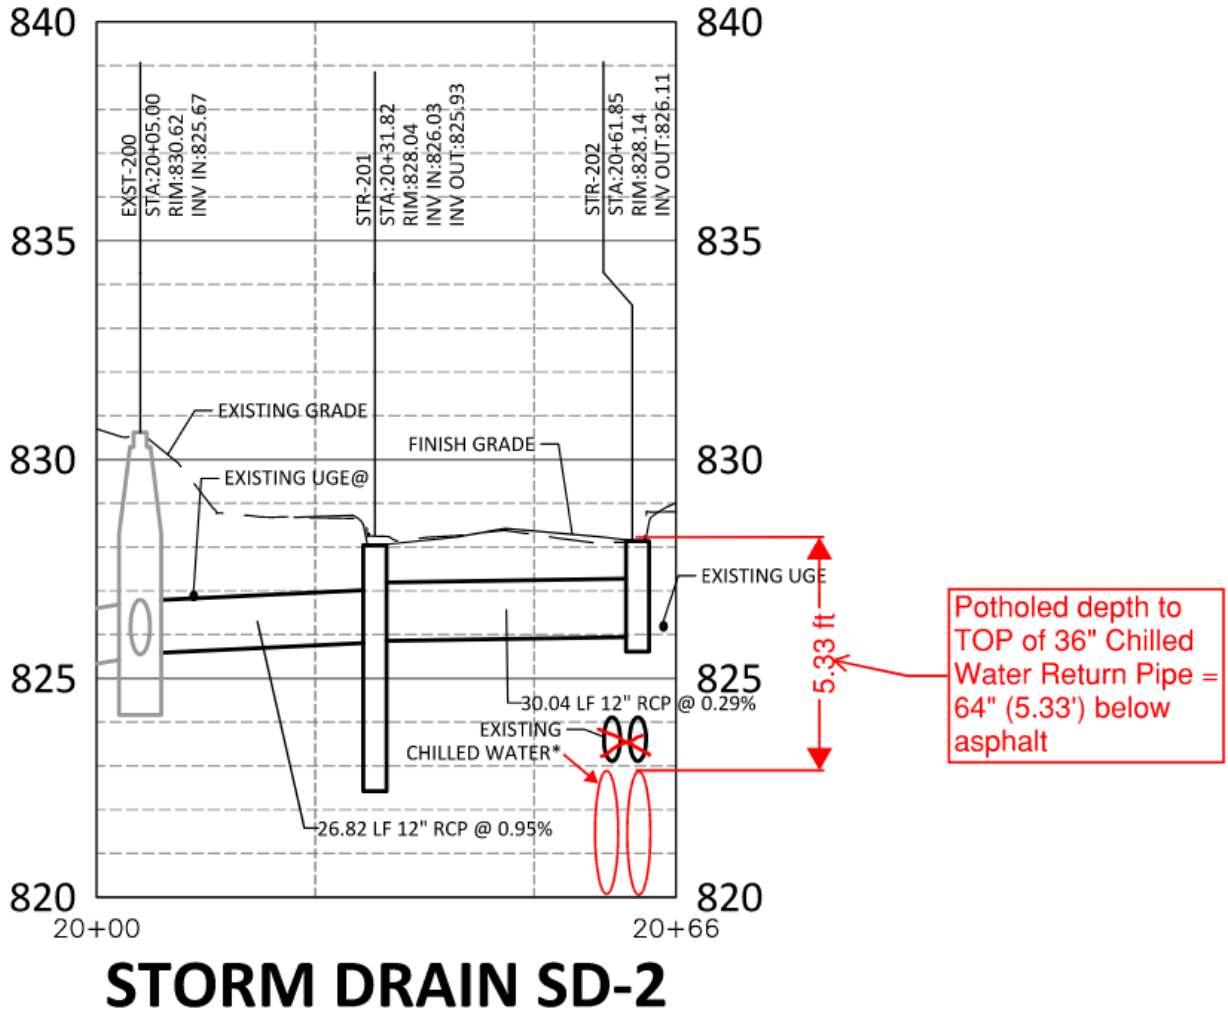

END OF ADDENDUM TWO